


UNDERGROUND SERVICE ALERT  
ONE-CALL NUMBER  
1-800-424-5555  
CALL TWO BUSINESS DAYS  
BEFORE YOU DIG

40 20 0 40 80  
SCALE 1" = 40' FEET  
EXISTING CONTOUR INTERVAL = 1 FOOT  
PROPOSED CONTOUR INTERVAL = 1 FOOT

NORTH

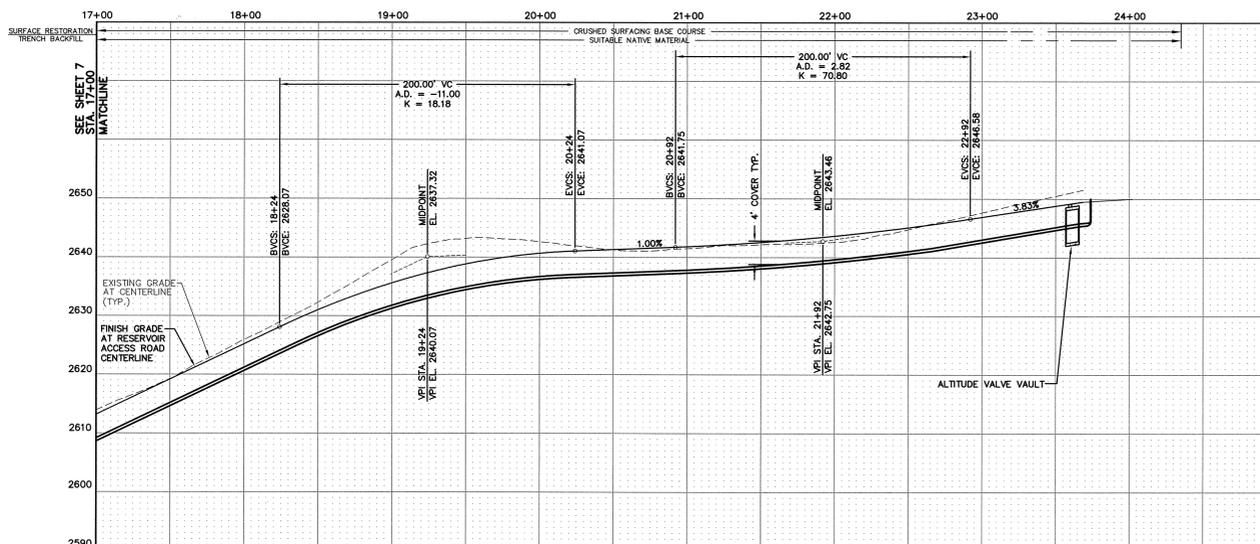


RECORD DRAWING  
PER FIELD SURVEY

UTILITY STATEMENT  
THE UNDERGROUND UTILITIES SHOWN HAVE BEEN LOCATED AS ACCURATELY AS POSSIBLE FROM FIELD SURVEY INFORMATION AND EXISTING DRAWINGS. TAYLOR ENGINEERING, INC. MAKES NO GUARANTEES THAT THE UNDERGROUND UTILITIES SHOWN COMPRISE ALL SUCH UTILITIES IN THE AREA, EITHER IN SERVICE OR ABANDONED. FURTHER, WE DO NOT WARRANT THAT THE UNDERGROUND UTILITIES SHOWN ARE IN EXACT LOCATION INDICATED, ALTHOUGH WE DO CERTIFY THAT THEY ARE LOCATED AS ACCURATELY AS POSSIBLE FROM INFORMATION AVAILABLE.

1	2/10	DWC	CRG	RECORD DRAWINGS																												
<table border="0"> <tr> <td>Drawn</td> <td>DJJ,BDB</td> <td>Date</td> <td>4/09</td> </tr> <tr> <td>Designed</td> <td>BAN,MFM,CRG</td> <td>Date</td> <td>11/08</td> </tr> <tr> <td>Checked By</td> <td>RGP</td> <td>Date</td> <td>6/09</td> </tr> </table>					Drawn	DJJ,BDB	Date	4/09	Designed	BAN,MFM,CRG	Date	11/08	Checked By	RGP	Date	6/09																
Drawn	DJJ,BDB	Date	4/09																													
Designed	BAN,MFM,CRG	Date	11/08																													
Checked By	RGP	Date	6/09																													
<table border="0"> <tr> <td colspan="2">Taylor Engineering, Inc.</td> <td colspan="2">CITY OF PULLMAN, WASHINGTON</td> <td>SCALE</td> <td>AIRPORT FIRE FLOW SYSTEM</td> <td>WATER</td> </tr> <tr> <td colspan="2">Civil Design and Land Planning</td> <td colspan="2">ENGINEERING DIVISION</td> <td>HORIZ 1"=40'</td> <td>6" WATER FILL LINE</td> <td>SHEET</td> </tr> <tr> <td colspan="2">246 E. Main St.</td> <td colspan="2"></td> <td>VERT. 1"=10'</td> <td>STA. 16+50 TO 23+74</td> <td>8</td> </tr> <tr> <td colspan="2">(509) 334-5115 FAX (509) 334-5956</td> <td colspan="2"></td> <td></td> <td></td> <td>22</td> </tr> </table>					Taylor Engineering, Inc.		CITY OF PULLMAN, WASHINGTON		SCALE	AIRPORT FIRE FLOW SYSTEM	WATER	Civil Design and Land Planning		ENGINEERING DIVISION		HORIZ 1"=40'	6" WATER FILL LINE	SHEET	246 E. Main St.				VERT. 1"=10'	STA. 16+50 TO 23+74	8	(509) 334-5115 FAX (509) 334-5956						22
Taylor Engineering, Inc.		CITY OF PULLMAN, WASHINGTON		SCALE	AIRPORT FIRE FLOW SYSTEM	WATER																										
Civil Design and Land Planning		ENGINEERING DIVISION		HORIZ 1"=40'	6" WATER FILL LINE	SHEET																										
246 E. Main St.				VERT. 1"=10'	STA. 16+50 TO 23+74	8																										
(509) 334-5115 FAX (509) 334-5956						22																										
<table border="0"> <tr> <td>No.</td> <td>Date</td> <td>By</td> <td>Ckd.</td> <td>Appr.</td> <td>Revisions</td> </tr> <tr> <td> </td> <td> </td> <td> </td> <td> </td> <td> </td> <td> </td> </tr> </table>					No.	Date	By	Ckd.	Appr.	Revisions																						
No.	Date	By	Ckd.	Appr.	Revisions																											


07042P-FLL(2)(3).dwg

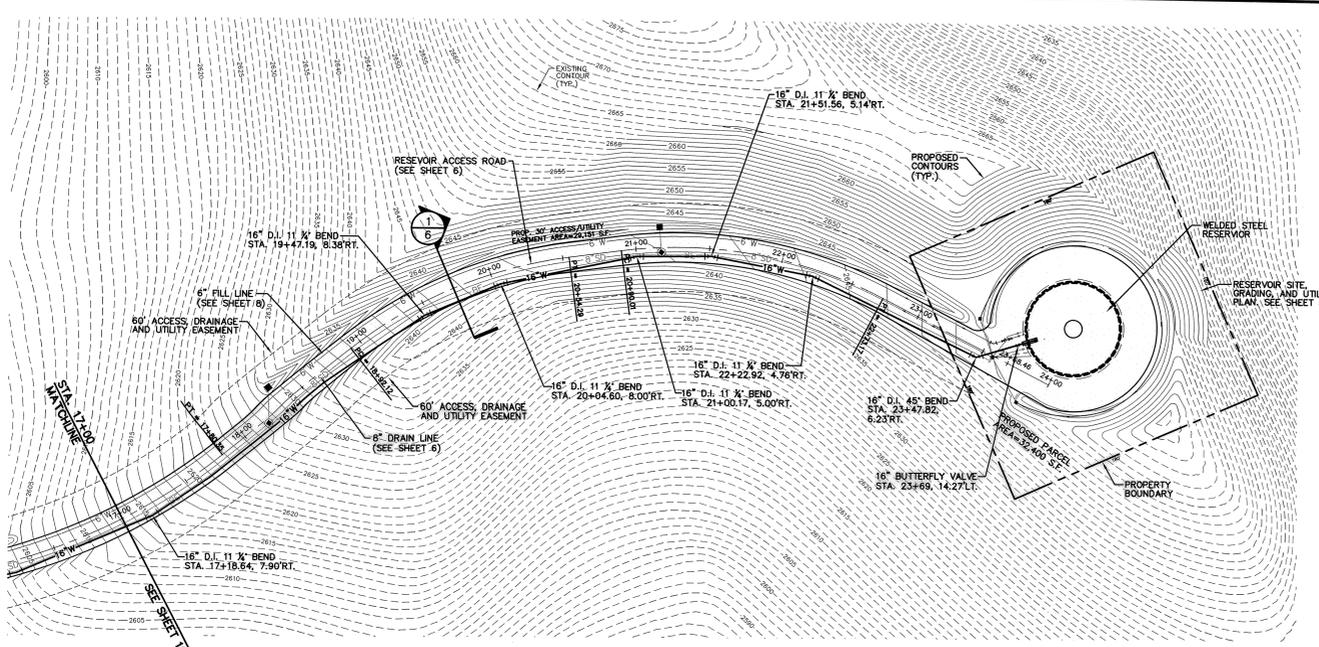

UNDERGROUND SERVICE ALERT  
ONE-CALL NUMBER  
1-800-424-5555  
CALL TWO BUSINESS DAYS  
BEFORE YOU DIG

40 20 0 40 80  
SCALE 1" = 40' FEET  
EXISTING CONTOUR INTERVAL = 1 FOOT  
PROPOSED CONTOUR INTERVAL = 1 FOOT

NORTH

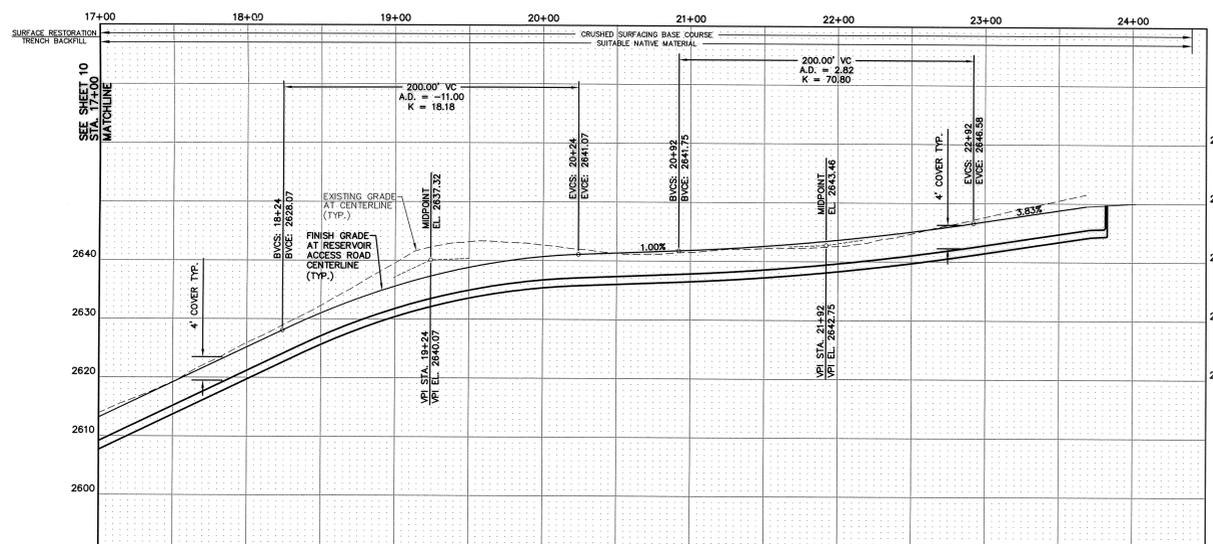

RECORD DRAWING  
PER FIELD SURVEY

UTILITY STATEMENT  
THE UNDERGROUND UTILITIES SHOWN HAVE BEEN LOCATED AS ACCURATELY AS POSSIBLE FROM FIELD SURVEY INFORMATION AND EXISTING DRAWINGS. TAYLOR ENGINEERING, INC. MAKES NO GUARANTEES THAT THE UNDERGROUND UTILITIES SHOWN COMPRISE ALL SUCH UTILITIES IN THE AREA, EITHER IN SERVICE OR ABANDONED. FURTHER, WE DO NOT WARRANT THAT THE UNDERGROUND UTILITIES SHOWN ARE IN EXACT LOCATION INDICATED, ALTHOUGH WE DO CERTIFY THAT THEY ARE LOCATED AS ACCURATELY AS POSSIBLE FROM INFORMATION AVAILABLE.

1	2/10	DWC	CRG	RECORD DRAWINGS																												
<table border="0"> <tr> <td>Drawn</td> <td>DJJ,BDB</td> <td>Date</td> <td>4/09</td> </tr> <tr> <td>Designed</td> <td>BAN,MFM,CRG</td> <td>Date</td> <td>11/08</td> </tr> <tr> <td>Checked By</td> <td>RGP</td> <td>Date</td> <td>6/09</td> </tr> </table>					Drawn	DJJ,BDB	Date	4/09	Designed	BAN,MFM,CRG	Date	11/08	Checked By	RGP	Date	6/09																
Drawn	DJJ,BDB	Date	4/09																													
Designed	BAN,MFM,CRG	Date	11/08																													
Checked By	RGP	Date	6/09																													
<table border="0"> <tr> <td colspan="2">Taylor Engineering, Inc.</td> <td colspan="2">CITY OF PULLMAN, WASHINGTON</td> <td>SCALE</td> <td>AIRPORT FIRE FLOW SYSTEM</td> <td>WATER</td> </tr> <tr> <td colspan="2">Civil Design and Land Planning</td> <td colspan="2">ENGINEERING DIVISION</td> <td>HORIZ 1"=40'</td> <td>16" WATER DISTRIBUTION LINE</td> <td>SHEET</td> </tr> <tr> <td colspan="2">246 E. Main St.</td> <td colspan="2"></td> <td>VERT. 1"=10'</td> <td>STA. 17+00 TO 23+82</td> <td>9</td> </tr> <tr> <td colspan="2">(509) 334-5115 FAX (509) 334-5956</td> <td colspan="2"></td> <td></td> <td></td> <td>22</td> </tr> </table>					Taylor Engineering, Inc.		CITY OF PULLMAN, WASHINGTON		SCALE	AIRPORT FIRE FLOW SYSTEM	WATER	Civil Design and Land Planning		ENGINEERING DIVISION		HORIZ 1"=40'	16" WATER DISTRIBUTION LINE	SHEET	246 E. Main St.				VERT. 1"=10'	STA. 17+00 TO 23+82	9	(509) 334-5115 FAX (509) 334-5956						22
Taylor Engineering, Inc.		CITY OF PULLMAN, WASHINGTON		SCALE	AIRPORT FIRE FLOW SYSTEM	WATER																										
Civil Design and Land Planning		ENGINEERING DIVISION		HORIZ 1"=40'	16" WATER DISTRIBUTION LINE	SHEET																										
246 E. Main St.				VERT. 1"=10'	STA. 17+00 TO 23+82	9																										
(509) 334-5115 FAX (509) 334-5956						22																										
<table border="0"> <tr> <td>No.</td> <td>Date</td> <td>By</td> <td>Ckd.</td> <td>Appr.</td> <td>Revisions</td> </tr> <tr> <td> </td> <td> </td> <td> </td> <td> </td> <td> </td> <td> </td> </tr> </table>					No.	Date	By	Ckd.	Appr.	Revisions																						
No.	Date	By	Ckd.	Appr.	Revisions																											

07042P-DST-LIN(3).dwg